


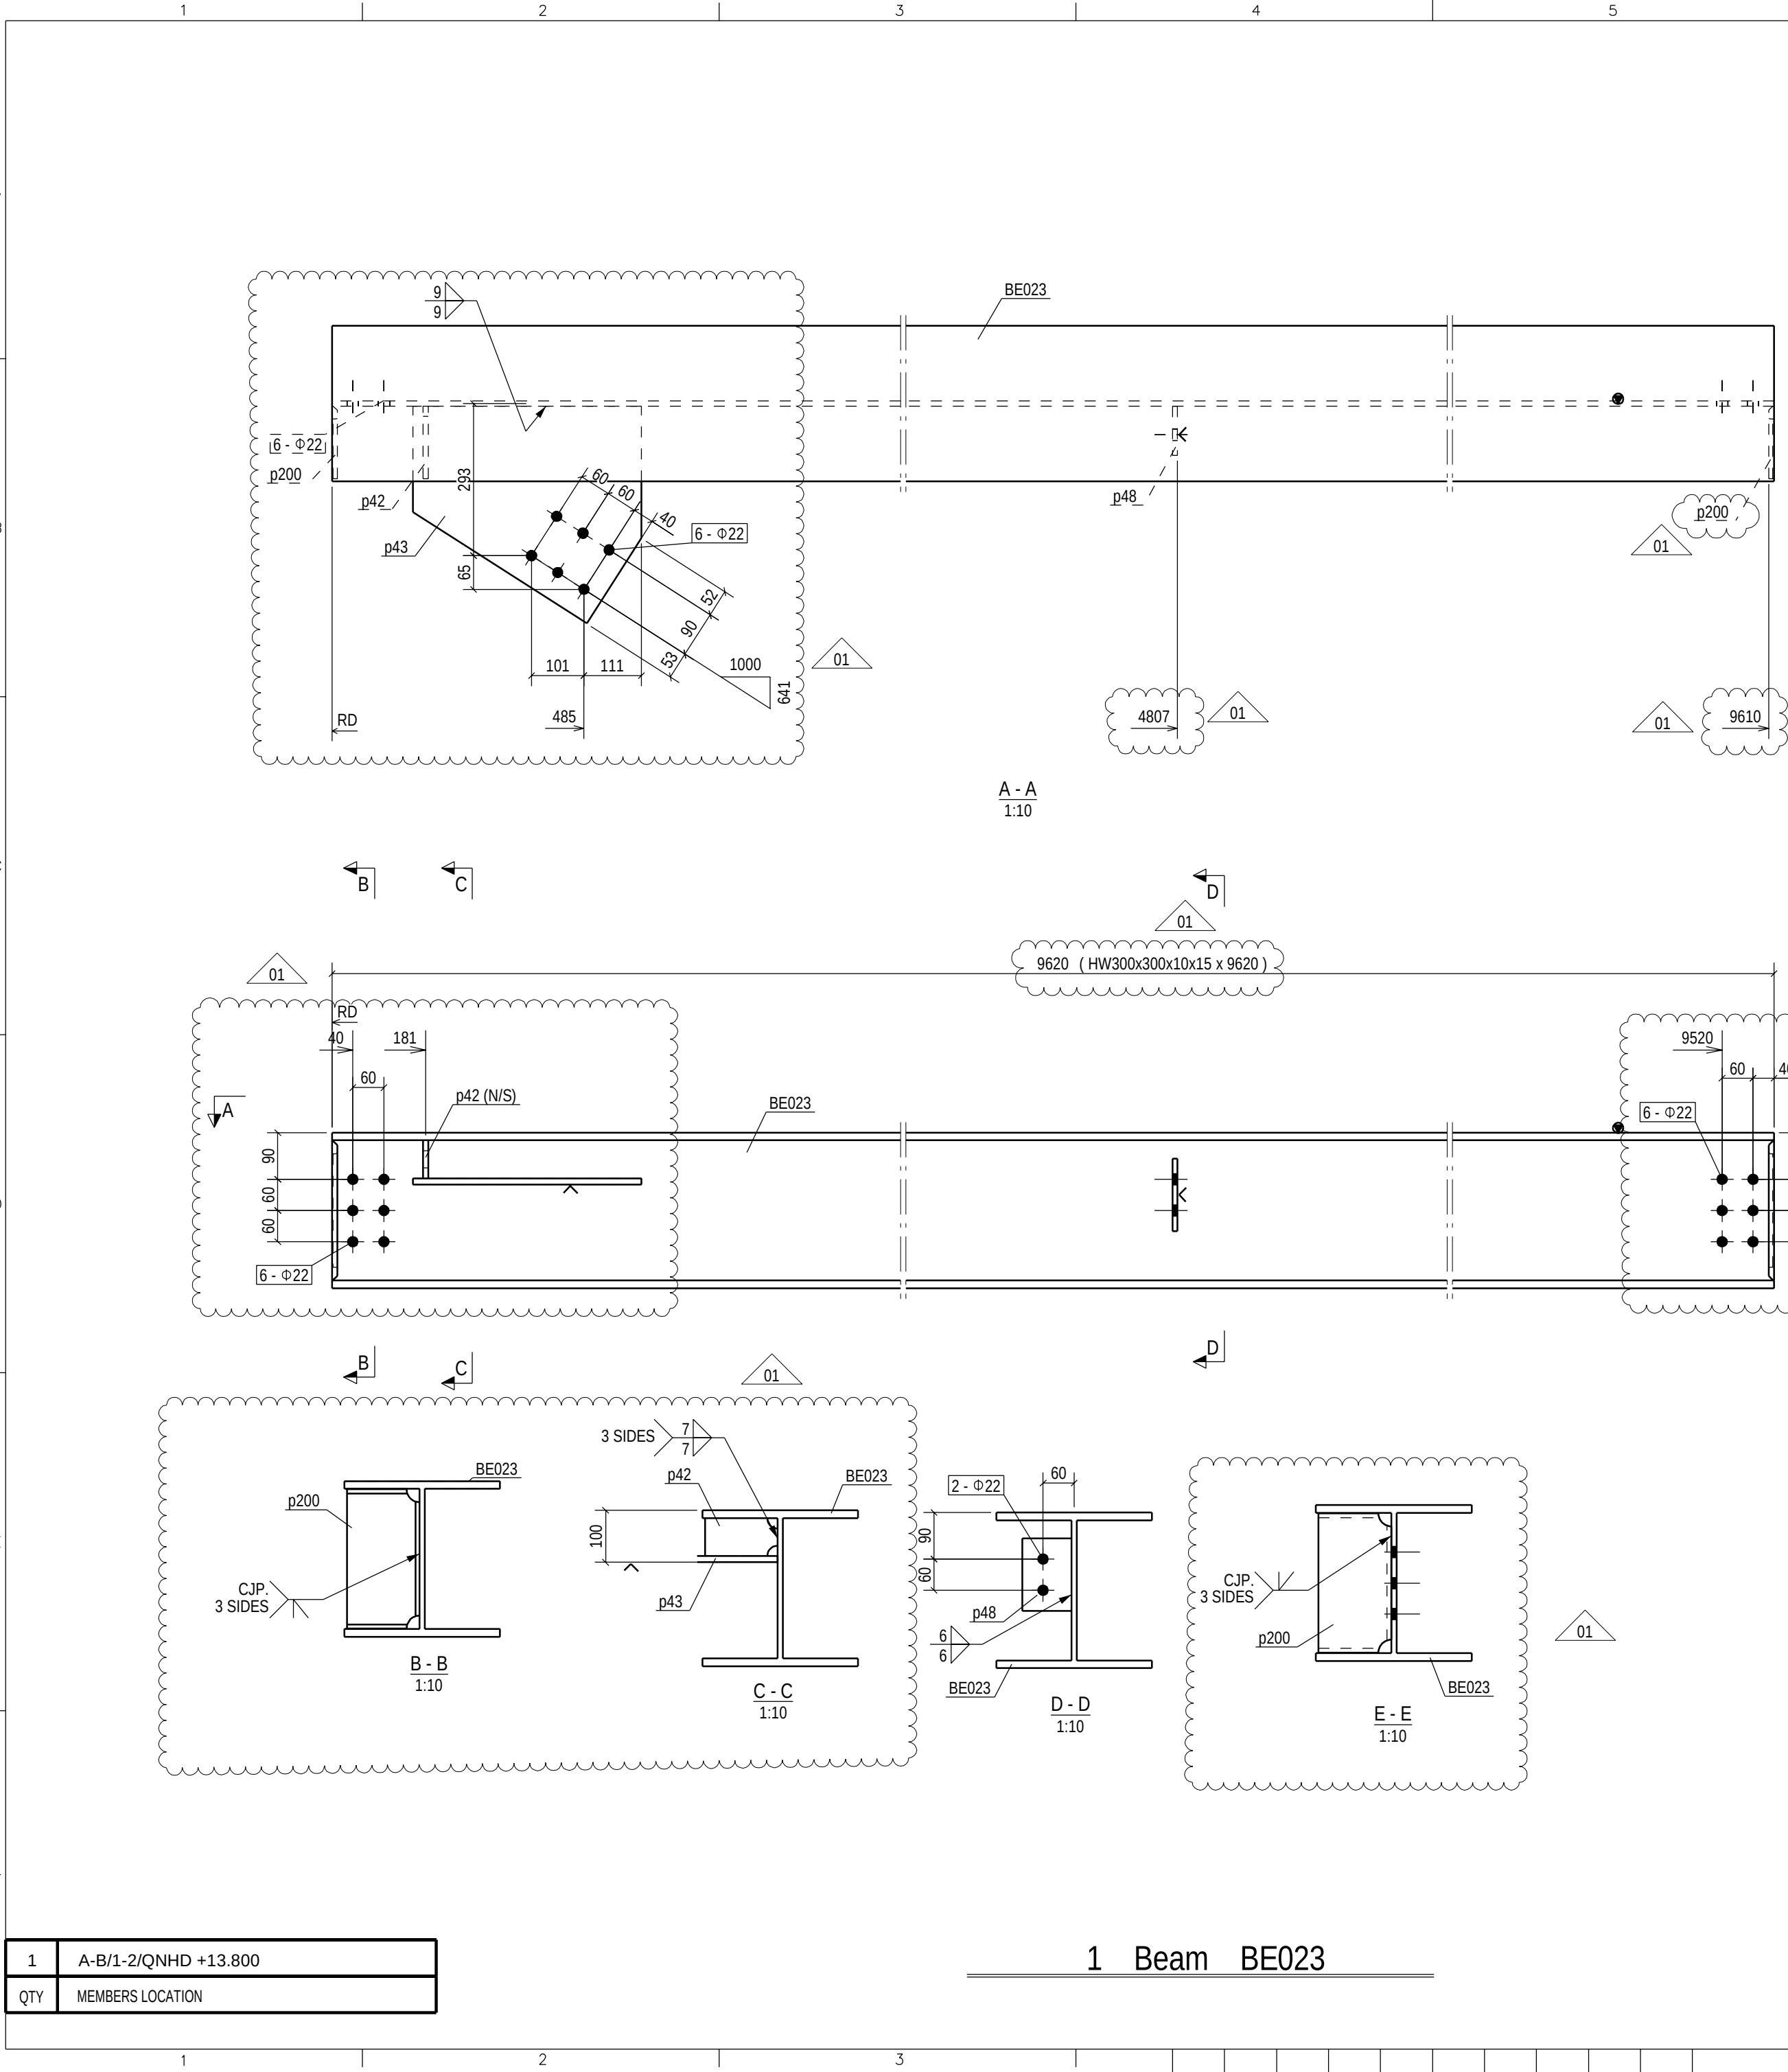

Length 长度(mm)	Width 宽度(mm)	Height 高度(mm)	Pay Cat. 付款等级	Line 行号	Qty. 数量	Mark 构件号	Sub Mark 次构件号	Description 截面尺寸	Material 材质	Length 长度(mm)	Finish 油漆	ABM 材料订单号	Weight 重量(kg)	REMARK 备注
9620	574	300		1	1	BE023		Beam						
1810.02.10.03.12				2	1		BE023	HW300x300x10x15	Q355B	9620	G		885.53	
1810.02.10.03.12				3	1		p42	PL10x73	Q355B	140	G		0.75	
1810.02.10.03.12				4	1		p43	PL12x118.7	Q355B	440	G		13.16	
1810.02.10.03.12				5	1		p48	PL10x65	Q355B	140	G		1.10	01
1810.02.10.03.12				6	2		p200	PL10x140	Q355B	268	G		5.51	
												TOTAL	910.00	

ASSEMBLY BOLT LIST (FOR 1 ASSEMBLY)					
Dia.	Grade	Pay Code	Length	No.	Site/Shop
20	A325M	G	C1	55	12
(Mechanical galvanized only for DTI washer)					

01	24SEP25	ISSUE FOR FABRICATION	WVF	WVF	YF	YF				
00	23JUN25	ISSUE FOR FABRICATION	WVF	WVF	YF	YF				
REV	DATE	REVISION	BY	CHKD	APVD	APVD				
PURCHASERS PERMISSION TO PROCEED OR REVIEW TAKEN ON VENDOR PRINTS SHALL NOT RELIEVE VENDOR FROM ITS RESPONSIBILITIES UNDER PURCHASE ORDER.										
RETURN TO VENDOR			RESPOND BY							
☐ 1 REVISE AND RESUBMIT										
☐ 2 TO BE ISSUED AS FINAL PROVIDED COMMENTS ARE INCORPORATED										
☐ 3 NOT COMMENT - FINAL ISSUE										
☐ 4 FOR INFORMATION ONLY										
North Field South Project Onshore LNG Facilities										
THIS DOCUMENT IS PROPERTY OF QATAR ENERGY. THIS DRAWING OR MATERIAL DESCRIBED THEREIN MAY NOT BE COPIED OR DISCLOSED IN ANY FORM OR MEDIUM TO A THIRD PARTY, REL OR USED FOR OR HER TO HAVE THE PURPOSE FOR WHICH IT HAS BEEN PROVIDED, IN WHOLE OR IN PART, IN ANY MANNER EXCEPT AS EXPRESSLY PERMITTED BY QATAR ENERGY LTD.										
COMPANY CONTRACT NO.:			CONTRACTOR JOB NO.:							
P.O.:			215777C008-00000-PO-1800-20301-NFSS20							
REQUISITION NO.:			NFS_EPC-TECC-ST-REQ-20301							
EQUIPMENT NAME:			PACKAGE - III- STEELSTRUCTURES (Offsite Area)							
TAG NO.:			361-RC3210-S-01							
VENDOR NAME:			UNITED STEEL STRUCTURES LTD.							
DOCUMENT CLASS:			3							
VENDOR DOCUMENT NO.:			ST20301-02048							
TITLE										
INLET AREA										
STEEL STRUCTURE DRAWING										
361-RC3210-S-01-BE023										
SCALE			PROJECT NO.							
1:10			LTC/CNFS/5496/21							
PROJECT			PROJECT DOCUMENT NO.		SHEET NO.					
NFS			5496_21-ST20301-02045		1					
			SIZE		REVISION					
			A2		01					

1. ACCUMULATIVE DIMENSIONS ARE TAKEN FROM THE "RD" LINE. 测量尺寸是根据该线"RD"开始计算。
2. ALL GAS RE-ENTRANT CUTS WILL HAVE A RADIUS OF 3mm U.N.O. 所有气体重返切口要有3mm圆角。 除另有说明。
3. ALL SUBMARKS THIS SHEET TO BE PREPARED (361-RC3210-S-01). 这些图例的所有标注都要按照 (361-RC3210-S-01)
4. ASSEMBLY MARK TO BE STAMPED ON THE FACE WHERE INDICATED THUS: ● 为构件组合面, 工厂家标注。
5. "Y" DENOTES THE TOUCH FACE OF MEMBERS. SHOP MUST SPOT THEM. "Y" 为构件组合面, 工厂家标注。
6. ALL THE DIAMETER OF SCALLOP IS 25mm U.N.O. 所有圆角切口半径都是25mm。 除另有说明。
7. ALL WELDS SHALL BE CONTINUOUS U.N.O. 所有焊缝都是连续焊缝。 除另有说明。
8. SEAL WELDS OF 3mm FILLET WELD SHALL BE PROVIDED IN WELD DEED CONNECTIONS. 焊缝节点处的封焊是3mm的焊缝。
9. TEMPORARY BOLTS SHALL BE RED COATED TO DISTINGUISH FROM THE PERMANENT BOLT. 临时螺栓涂红漆, 以便与永久螺栓。

1	A-B/1-2/QNHD +13.800
QTY	MEMBERS LOCATION

1 Beam BE023