



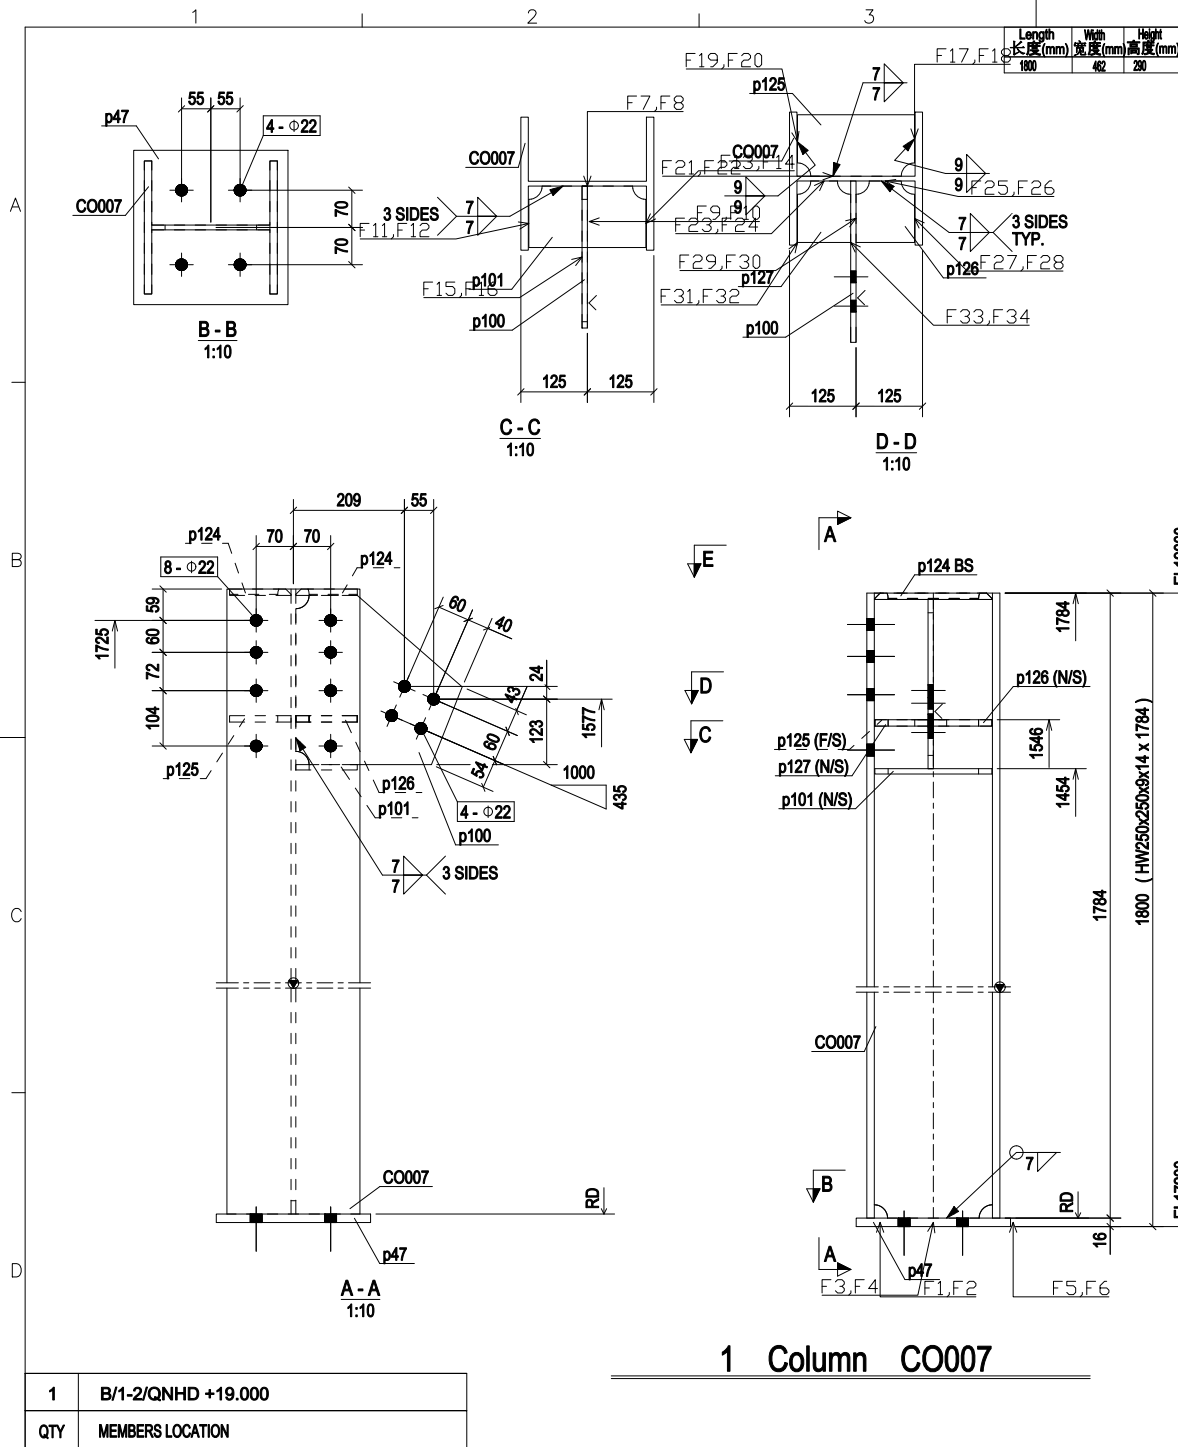

Pay Cat. 付款等级	Line 行号	Qty. 数量	Mark 构件号	Sub Mark 次构件号	Description 描述尺寸	Material 材质	Length 长度 (mm)	Finish 油漆	ABM 材料订单号	Weight 重量 (kg)	REMARK 备注
	1	1	CO007		Column						
1810.02.10.03.12	2	1		CO007	HW250x250x14	Q355B	1784	G		128.13	
1810.02.10.03.12	3	1		p47	PL16x290	Q355B	290	G		10.58	
1810.02.10.03.12	4	1		p100	PL10x12.7	Q355B	318	G		6.07	
1810.02.10.03.12	5	1		p101	PL10x115.5	Q355B	220	G		1.92	
1810.02.10.03.12	6	2		p124	PL12x115.5	Q355B	220	G		4.33	
1810.02.10.03.12	7	1		p125	PL12x115.5	Q355B	220	G		2.30	
1810.02.10.03.12	8	1		p126	PL12x110	Q355B	116	G		1.10	
1810.02.10.03.12	9	1		p127	PL12x100	Q355B	116	G		1.00	
TOTAL										155.41	

ASSEMBLY BOLT LIST (FOR 1 ASSEMBLY)					
Dia.	Grade	Pay Code	Length	No.	Site/Shop
20	A325M	G	C1	70	4
20	A325M-DTI	G	C1	75	8

(Mechanical galvanized only for DTI washer)

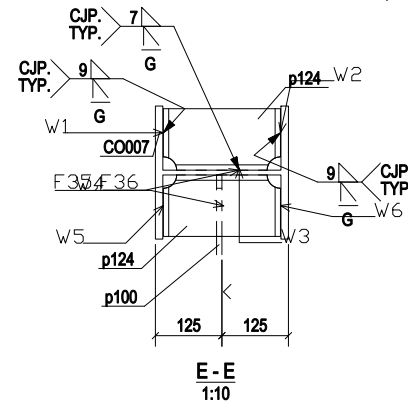

00	23JUN25	ISSUE FOR FABRICATION	WF	WW	YF	YF
REV	DATE	REVISION	BY	CHKD	APVD	APVD
			PURCHASER'S PERMISSION TO PROCEED OR REVIEW TAKEN ON VENDOR PRINTS SHALL NOT RELIEVE VENDOR FROM ITS RESPONSIBILITIES UNDER PURCHASE ORDER.			
RETURN TO VENDOR			RESPOND BY			
☐ 1 REVISE AND RESUBMIT						
☐ 2 TO BE ISSUED AS FINAL PROVIDED COMMENTS ARE INCORPORATED						
☐ 3 NOT COMMENT - FINAL ISSUE						
☐ 4 FOR INFORMATION ONLY						
North Field South Project Onshore LNG Facilities						
THIS DOCUMENT IS PROPERTY OF QATARENERGY. IT IS TO BE USED ONLY FOR THE PROJECT AND NOT BE REPRODUCED OR TRANSMITTED IN ANY FORM OR BY ANY MEANS, ELECTRONIC OR MECHANICAL, WITHOUT PERMISSION FROM QATARENERGY.						
COMPANY CONTRACT NO.:		LTCQNF8649821		CONTRACTOR JOB NO.:		N/A
P.O.:		215777/CO08-00000-PO-1800-20301-NFS820				
REQUISITION NO.:		NFS_EPC-TECC-ST-REQ-20301				
EQUIPMENT NAME:		PACKAGE - III- STEEL STRUCTURES (Offshore Area)				
TAG NO.:		361-RC3210-S-01				
VENDOR NAME:		UNITED STEEL STRUCTURES LTD.				
DOCUMENT CLASS:		3				
VENDOR DOCUMENT NO.:		ST20301-02048				
TITLE INLET AREA STEEL STRUCTURE DRAWING 361-RC3210-S-01-CO007						
SCALE		1:10		PROJECT NO.		LTCQNF8649821
PROJECT		NFS		PROJECT DOCUMENT NO.		5496_21-ST20301-02045
SHEET NO.		1		SIZE		A3
REVISION		00		REVISION		

1. ACCUMULATIVE DIMENSIONS ARE TAKEN FROM THE "TOP" LINE. 累积尺寸系从顶部线 "TOP" 开始计算。
2. ALL DIMENSIONS SHALL HAVE A TOLERANCE OF ± 1.0 mm UNLESS OTHERWISE SPECIFIED. 所有尺寸公差默认为 ± 1.0 mm，除非另有规定。
3. ALL DIMENSIONS THIS SHEET TO BE PROVIDED DIMENSIONS SHALL BE IN MILLIMETERS. 本图所有尺寸均为毫米，除非另有规定。
4. ASSEMBLY MARK TO BE STAMPED ON THE FACE WHERE INDICATED THEREIN. 构件号应打在图中标注的位置上。
5. "P" INDICATES THE TOUCH FACE OF MEMBERS, SHIP MUST SPOT THEM. "P" 为接触面，船方必须点焊。
6. ALL THE DIAMETER OF SCALLOP IS 25mm UNLESS OTHERWISE SPECIFIED. 所有圆孔直径均为 25mm，除非另有规定。
7. ALL WELDS SHALL BE CONTINUOUS UNLESS OTHERWISE SPECIFIED. 所有焊缝均为连续焊缝，除非另有规定。
8. REAL WELDS OF 3MM FILLET WELD SHALL BE PROVIDED IN WELDED CONNECTIONS. 所有节点处应提供 3mm 角焊缝。
9. TOP SURFACES SHALL BE RED COATED TO CORROSION FROM THE PERMANENT MOIST. 所有顶面应涂红漆以防永久潮湿腐蚀。