Length 长度(mm)	Width 宽度(mm)	Height 高度(mm)
9620	627	300

Pay Cat. 付款等级	Line 行号	Qty. 数量	Mark 构件号	Sub Mark 次构件号	Description 截面尺寸	Material 材质	Length 长度(mm)	Finish 油漆	ABM 材料订单号	Weight 重量(kg)	REMARK 备注
	1	1	BE022		Beam						
1810.02.10.03.12	2	1		BE022	HW300x300x10x15	Q355B	9620	G		895.53	
1810.02.10.03.12	3	2		p18	PL10x69	Q355B	140	G		1.42	
1810.02.10.03.12	4	2		p19	PL16x472.1	Q355B	534	G		46.68	01
1810.02.10.03.12	5	1		p26	PL10x95	Q355B	200	G		1.49	
1810.02.10.03.12	6	2		p200	PL10x140	Q355B	268	G		5.51	
									TOTAL	950.63	

ASSEMBLY BOLT LIST (FOR 1 ASSEMBLY)

Dia.	Grade		Pay Code	Length	No.	Site/Shop
20	A325M	G	C1	55	12	Site

(Mechanical galvanized only for DTI washer)

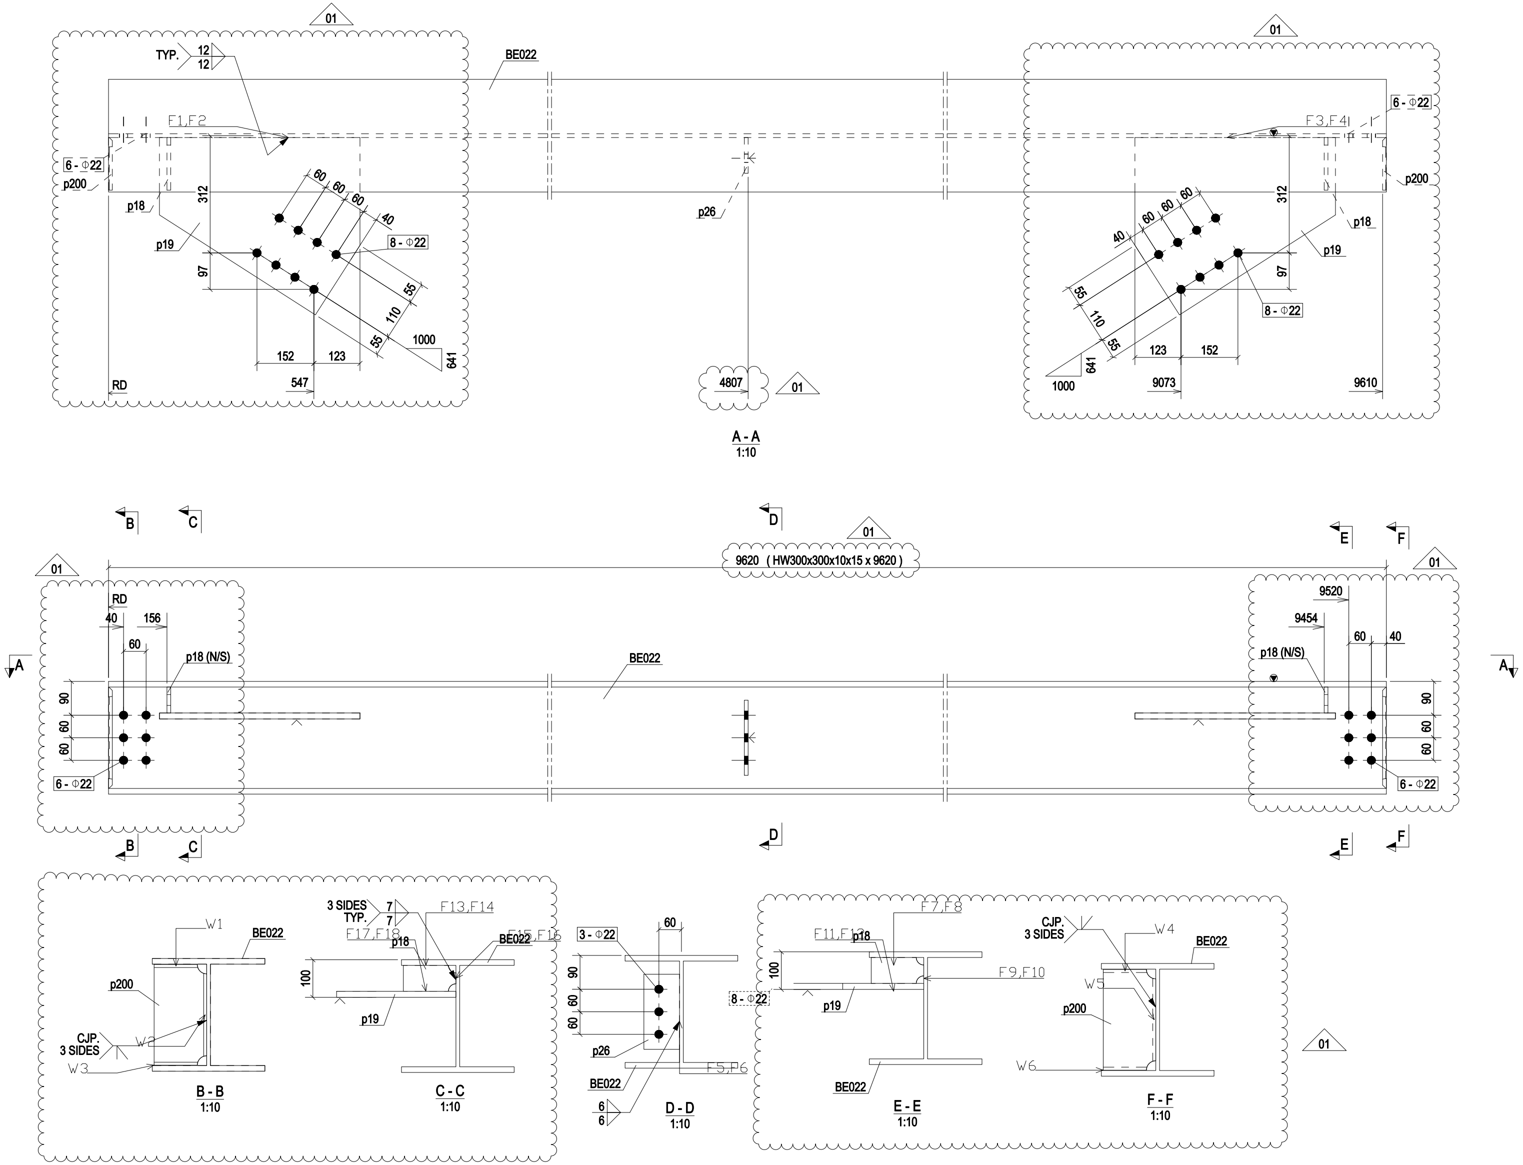

1	A-B/1-2/QNHD +10.400
QTY	MEMBERS LOCATION

1 Beam BE022

1. ACCUMULATIVE DIMENSIONS ARE TAKEN FROM THE "RD" LINE. 积累尺寸是根据这线 "RD" 开始计算。
2. ALL GAS RE-ENTRANT CUTS WILL HAVE A RADIUS OF 10mm U.N.O. 所有气割直角切口要有10mm 的半径, 除另有所指。
3. ALL SUBMARKS THIS SHEET TO BE PREFIXED(361-RC3210-S-01). 这张图样的所有副标记前面要加(361-RC3210-S-01)。
4. ASSEMBLY MARK TO BE STAMPED ON THE FACE WHERE INDICATED THUS . 构件号打在 标记面上。
5. ">" DENOTES THE TOUCH FACE OF MEMBERS, SHOP MUST SPOT THEM. ">" 为构件结合面, 工厂需标识出来。
6. ALL THE DIAMETER OF SCALLOP IS 25mm U.N.O. 所有扇形倒角半径都是25mm, 除另有所指。
7. ALL WELDS SHALL BE CONTINUOUS, U.N.O. 所有焊缝都是连续焊缝, 除另有所指。
8. SEAL WELDS OF 3MM FILLET WELD SHALL BE PROVIDED IN WELDED CONNECTIONS. 焊接节点里的封焊是3mm角焊缝。
9. TEMPORARY BOLTS SHALL BE RED COATED TO DISTIGUISH FROM THE PERMANENT BOLT. 临时螺栓应涂红油漆, 以区别与永久螺栓。

REV	DATE	REVISION	BY	CHKD	APVD	APVD
01	24SEP25	ISSUE FOR FABRICATION	WYF	WYW	Y.F	Y.F
00	23JUN25	ISSUE FOR FABRICATION	WYF	WYW	Y.F	Y.F

T.EN CCC JV

PURCHASER'S PERMISSION TO PROCEED OR REVIEW TAKEN ON VENDOR PRINTS SHALL NOT RELIEVE VENDOR FROM ITS RESPONSIBILITIES UNDER PURCHASE ORDER.

RETURN TO VENDOR — RESPOND BY

- ☐ 1 REVISE AND RESUBMIT
- ☐ 2 TO BE ISSUED AS FINAL PROVIDED COMMENTS ARE INCORPORATED
- ☐ 3 NOT COMMENT - FINAL ISSUE
- ☐ 4 FOR INFORMATION ONLY

North Field South Project
Onshore LNG Facilities

QatarEnergy LNG

THIS DOCUMENT IS PROPERTY OF QATARENERGY LNG.THIS DRAWING OR MATERIAL DESCRIBED THEREON MAY NOT BE COPIED OR DISCLOSED IN ANY FORM OR MEDIUM TO THIRD PARTIES, OR USED FOR OTHER THAN THE PURPOSE FOR WHICH IT HAS BEEN PROVIDED, IN WHOLE OR IN PART IN ANY MANNER EXCEPT AS EXPRESSLY PERMITTED BY QATARENERGY LNG.

USSL United Steel Structures,Ltd.

COMPANY CONTRACT NO.: LTC/C/NFS/5496/21 — CONTRACTOR JOB NO.: N/A

P.O: 215777C008-00000-PO-1800-20301-NFS520
REQUISITION NO.: NFS_EPC-TECC-ST-REQ-20301
EQUIPMENT NAME: PACKAGE - III- STEELSTRUCTURES (Offsite Area)
TAG NO.: 361-RC3210-S-01
VENDOR NAME: UNITED STEEL STRUCTURES LTD.
DOCUMENT CLASS: 3
VENDOR DOCUMENT NO.: ST20301-02048

TITLE
INLET AREA
STEEL STRUCTURE DRAWING
361-RC3210-S-01-BE022

SCALE 1:10		PROJECT NO. LTC/C/NFS/5496/21		
PROJECT	PROJECT DOCUMENT NO.	SHEET No.	SIZE	REVISION
NFS	5496_21-ST20301-02045	1	A2	01